GRANITE · FIRST CRACK

Not a quote. Not signed.


This PDF is the BoM API draft as Revu markups.
Every recovered line is already in the Markups List.

What to do in Revu

1. Open page 2 only ? that is the drawing. Alt+L is the first crack.
2. Filter NEED and CHECK. Those need your input. Do not re-type them.
3. Delete wrong. Fill missing. New marks show your author.
4. Save. Drop that save back into Granite to compare.
5. You still sign the quote. Granite does not.

A-40-1-1091 · PLAN 09 · 81 markups in the list
Page 3 is a glance of the same list if you open this PDF without Revu.
NEED = missing info. CHECK = a note. Off-sheet shelves keep H1 / H2 / H3.

FIRST CRACK · CHECK IN REVU · STILL NOT AN ORDER

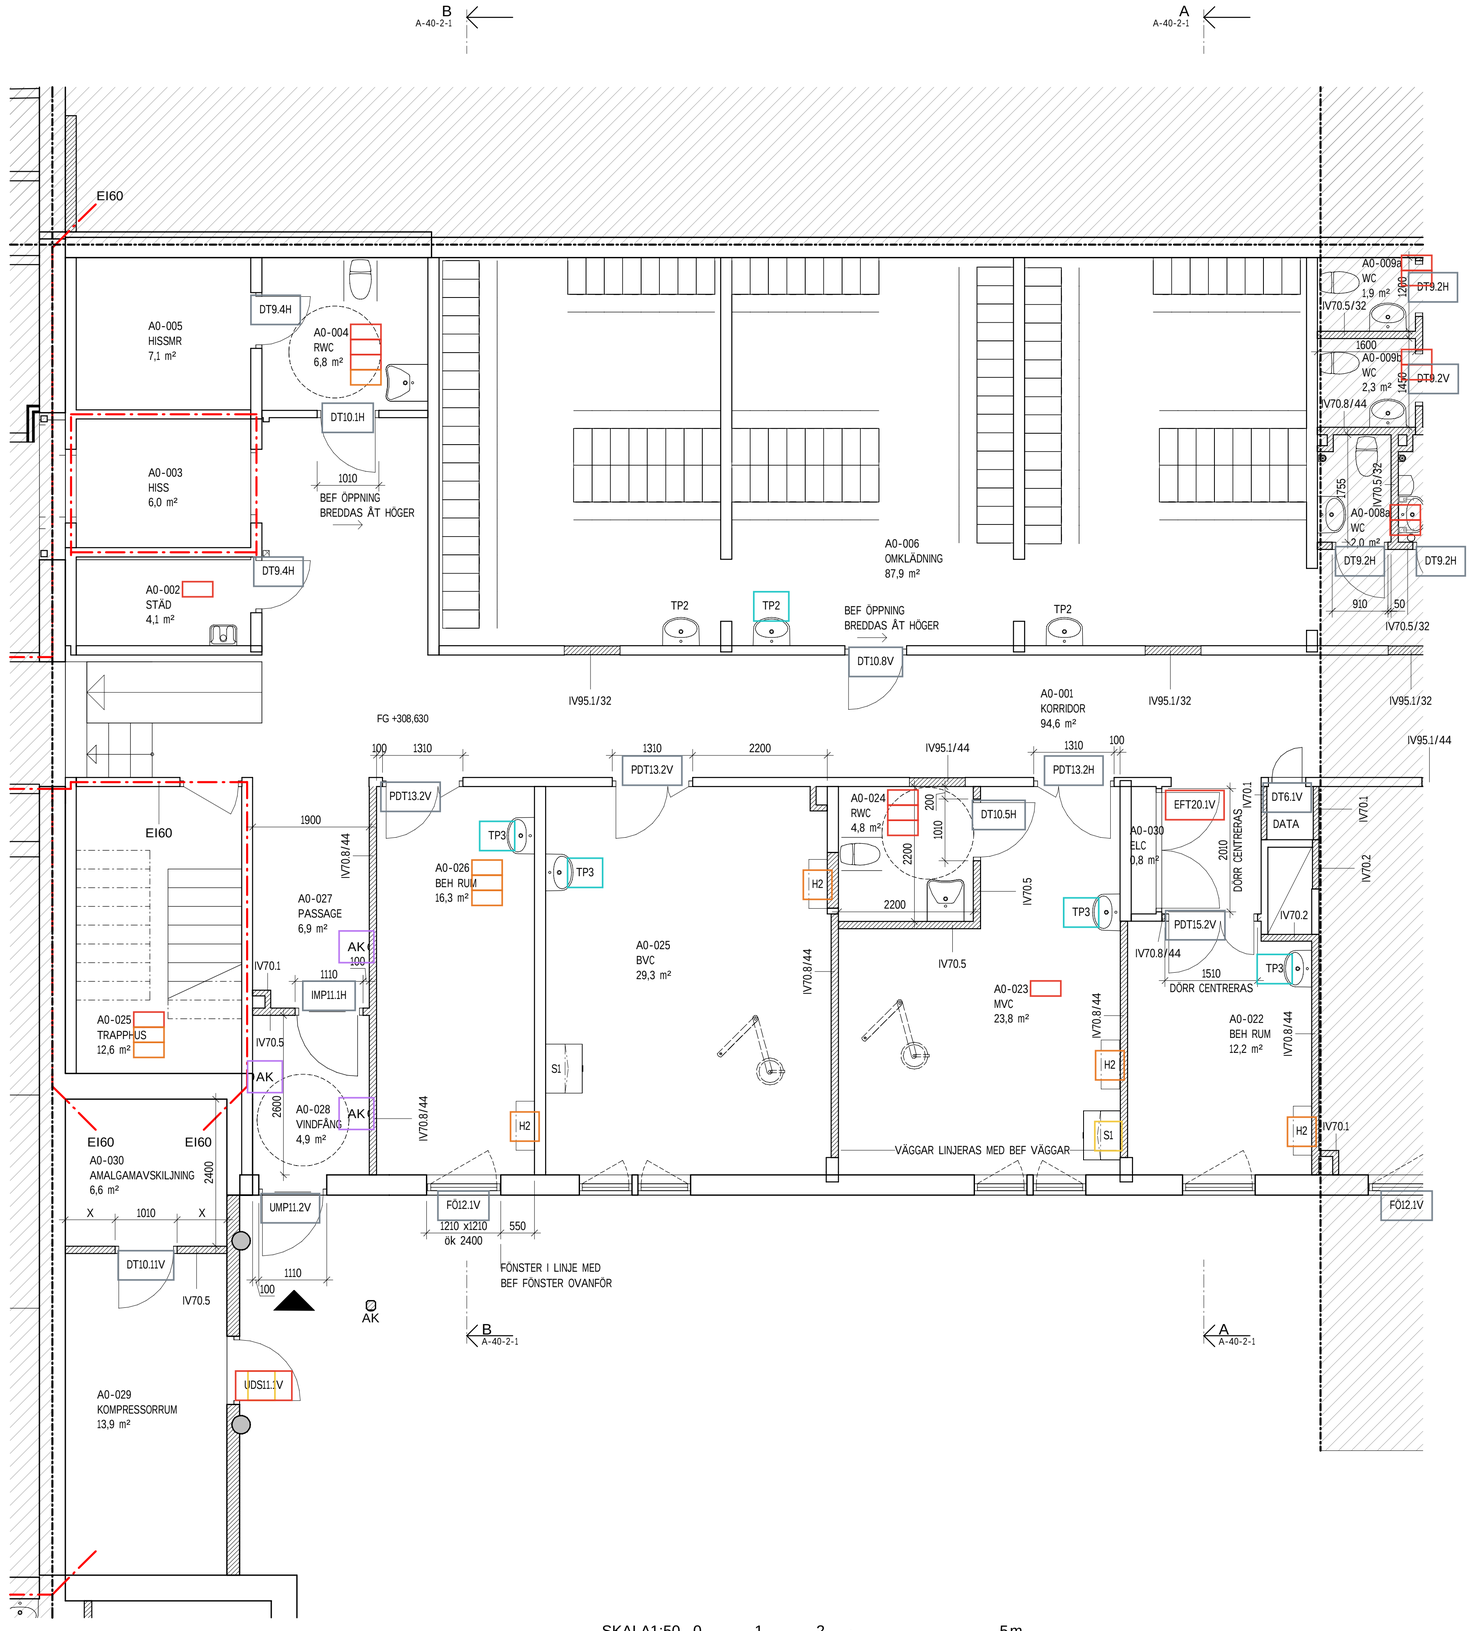

FÖRKLARINGAR

NYA BYGGDELAR

BEFINTLIGA BYGGDELAR

KONNEKTIONSLINJE

BRANDCELLSGRÄNSER:
E30
EI30
EI60

FG + 1,000 PLUSHÖJD FÄRDIGT GOgolv

VÄGGTYPER:
IV70.5 ANGER VÄGG MED REGEL 70 MM
IV70.5/36 ANGER VÄGG MED LJUDKRAV $D_{nT,w}$ 36 dB

LITTERA:


AK	ARMATURÅGSKONTAKT
DT	DÖRR AV TRÄ
DTG	DÖRR AV TRÄ, GLASAD
PDT	PARDÖRR AV TRÄ
PDTG	PARDÖRR AV TRÄ, GLASAD
IMP	INVÄNDIGT METALLPARTI
IL	INSPEKTIONSLUCKA
UMP	UTVÄNDIGT METALLPARTI
GP	GLASPARTI AV TRÄ
FÖ	FÖNSTER ÖPPNINGSBART
K	KYLSKÅP
F	FRYS
KF	KYL/FRYS
DM	DISKMASKIN
M	MIKROVÅGSUGN
HS	HÖRNSKYDD
SG	SKRAPGALLER
TM	TORKMATTA
TP	TVÄTTPLATSUTRUSTNING
PL	PROVLUCKA

FÖRESKRIFTER

BRAND:
VÄGGAR SKA UTFÖRAS I BRANDKLASS ENL BRANDSKYDDSBESKRIVNING OCH BRANDCELLSINDELNING PÅ BRANDSKYDDSRITNINGAR.
VID AVVIKELSER MELLAN A- RITNINGAR OCH BRANDSKYDDSRITNINGAR GÄLLER UTFÖRANDE ENLIGT BRANDSKYDDSRITNINGAR.

INSPEKTIONSLUCKOR:
PLACERING OCH HÖJD SAMORDNAS MED VS

Littera	Typ	Antal	Brandklass
IL.4	HILA Inspektionslucka 300x300 mm	2	EI30
IL.5	IL.5 LK Ram/lucka UNI INB UNI 550 590 x 580 x 26 mm	16	-
IL.6	LK Ventilskåp med tillhörande lucka 250 x 250 X 95 mm	1	-
IL.7	IL.7 HILA Inspektionslucka 300x300 mm	2	-

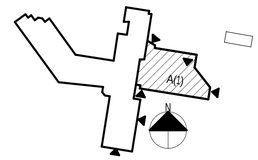

BET	ÄNDRINGEN AVSER	DATUM	SIGN

BYGGHANDLING

NY VÅRDBYGGNAD

EXEMPELVÄGEN 2

A	Exempel Arkitektstudio	tel. 000-000 00 00
K	KONSULT A	tel. 000-000 00 00
E	KONSULT A	tel. 000-000 00 00
V	KONSULT A	tel. 000-000 00 00
VS	KONSULT A	tel. 000-000 00 00
B	KONSULT C	tel. 000-000 00 00
M	KONSULT A	tel. 000-000 00 00
S	KONSULT A	tel. 000-000 00 00
GAS	KONSULT B	tel. 000-000 00 00
SP	KONSULT D	tel. 000-000 00 00

DATUM	RITAD/KONSTR AV	HANDLÄGGARE
2025-02-28	Arkitekt G	Arkitekt G
SKALA A1 1:50	ANSVARIG Arkitekt H	UPPDRAGSNR 90020

OM- OCH TILLBYGGNAD

FLYGEL A - PLAN 09, DEL 1
PLANRITNINGAR

FASTIGHETSNUMMER	NUMMER	BET
0001	A-40-1-1091	

2025-02-28 14:52:22

GLANCE · full API draft · not the work surface

Revu work is page 2 (drawing + Markups List). This page is the same 81 items as a table, so you can see what is there without hovering the drawing.

NEED 30 · CHECK 12 · On sheet 7 · OTHER TRADE 19 · OTHER 13

Other floors · listed as themselves · H1 A1-029 A1-045 A2-030 A3-035 · H2 A1-016 A1-017 A1-020 A1-023 A1-039 A1-040 A1-053 A2-040 · H3 A0-015

Subject	Flag	Qty	Room	Comment	What is missing / note
EFT20.1V	NEED	1	A0-030	EFT20.1V, ELC; description unavailable	The draft has a mark but no product type. Do not invent an article.
H2	NEED	1	A0-022	Hylla H2; length and specification unavailable	The floor plan marks the shelf. Length and spec are on the room description · that file
H2	NEED	1	A0-023	Hylla H2; length and specification unavailable	The floor plan marks the shelf. Length and spec are on the room description · that file
H2	NEED	1	A0-025	Hylla H2; length and specification unavailable	The floor plan marks the shelf. Length and spec are on the room description · that file
H2	NEED	1	A0-026	Hylla H2; length and specification unavailable	The floor plan marks the shelf. Length and spec are on the room description · that file
NEED	NEED	1	A0-002	Utslagsback	A sanitary symbol is drawn, but there is no type code. Need the setting-out / type stand
NEED	NEED	2	A0-004	Stödarm	A sanitary symbol is drawn, but there is no type code. Need the setting-out / type stand
NEED	NEED	1	A0-004	Tvättställ	A sanitary symbol is drawn, but there is no type code. Need the setting-out / type stand
NEED	NEED	1	A0-004	WC-stol	A sanitary symbol is drawn, but there is no type code. Need the setting-out / type stand
NEED	NEED	1	A0-008a	Tvättställ	A sanitary symbol is drawn, but there is no type code. Need the setting-out / type stand
NEED	NEED	1	A0-008a	WC-stol	A sanitary symbol is drawn, but there is no type code. Need the setting-out / type stand
NEED	NEED	1	A0-009a	Tvättställ	A sanitary symbol is drawn, but there is no type code. Need the setting-out / type stand
NEED	NEED	1	A0-009a	WC-stol	A sanitary symbol is drawn, but there is no type code. Need the setting-out / type stand
NEED	NEED	1	A0-009b	Tvättställ	A sanitary symbol is drawn, but there is no type code. Need the setting-out / type stand
NEED	NEED	1	A0-009b	WC-stol	A sanitary symbol is drawn, but there is no type code. Need the setting-out / type stand
NEED	NEED	1	A0-023	Unidentified articulated arm with circular head; product type to be confirmed	The draft has a mark but no product type. Do not invent an article.
NEED	NEED	2	A0-024	Stödarm	A sanitary symbol is drawn, but there is no type code. Need the setting-out / type stand
NEED	NEED	1	A0-024	Tvättställ	A sanitary symbol is drawn, but there is no type code. Need the setting-out / type stand
NEED	NEED	1	A0-024	WC-stol	A sanitary symbol is drawn, but there is no type code. Need the setting-out / type stand
NEED	NEED	1	A0-025	Unidentified articulated arm with circular head; product type to be confirmed	The draft has a mark but no product type. Do not invent an article.
NEED	NEED	1	·	Tvättställ, partially shown east of A0-008a	A sanitary symbol is drawn, but there is no type code. Need the setting-out / type stand
NEED	NEED	1	·	WC-stol, partially shown east of A0-008a	A sanitary symbol is drawn, but there is no type code. Need the setting-out / type stand
S1	NEED	1	A0-023	S1; description unavailable	The draft has a mark but no product type. Do not invent an article.
S1	NEED	1	A0-025	S1; description unavailable	The draft has a mark but no product type. Do not invent an article.
TP2	NEED	3	A0-006	TVÄTTPLATSUTRUSTNING	This is a package code. What is inside it comes from the type standard, which is not in
TP3	NEED	1	A0-022	TVÄTTPLATSUTRUSTNING	This is a package code. What is inside it comes from the type standard, which is not in
TP3	NEED	1	A0-023	TVÄTTPLATSUTRUSTNING	This is a package code. What is inside it comes from the type standard, which is not in
TP3	NEED	1	A0-025	TVÄTTPLATSUTRUSTNING	This is a package code. What is inside it comes from the type standard, which is not in
TP3	NEED	1	A0-026	TVÄTTPLATSUTRUSTNING	This is a package code. What is inside it comes from the type standard, which is not in
UDS11.1V	NEED	1	A0-029	UDS11.1V, KOMPRESSORRUM; description unavailable	The draft has a mark but no product type. Do not invent an article.
CHECK	CHECK	·	·	10 lines have no room (hatches, match-line items, one elbow tap).	Verify before you sign.
CHECK	CHECK	·	·	17 lines have no type code (WC, basin, support arms, unidentified arms).	Verify before you sign.
CHECK	CHECK	·	·	All 69 API lines are in this draft. The six recovered lines are other-floor request shelves,	Noted.
CHECK	CHECK	·	·	Doors, windows and metal frames are in the draft but kept out of the customer basket (other	Noted.
CHECK	CHECK	·	·	H2 is drawn, but length is not on this floor plan.	Verify before you sign.
CHECK	CHECK	·	·	Hatch quantities come from a table on the sheet, not from counting rooms.	Verify before you sign.
CHECK	CHECK	·	·	Only this PDF was uploaded. Ten other drawings, the room description and the type standard a	Verify before you sign.
CHECK	CHECK	·	·	Request-only shelves stay out of this basket: 4× H1, 8× H2, 1× H3 (A0-015). They stay on the	Noted.
CHECK	CHECK	·	·	S1, EFT20.1V, UDS11.1V and two articulated arms have no product type.	Verify before you sign.
CHECK	CHECK	·	·	TP3 / TP2 are package codes. Contents need the type standard.	Verify before you sign.
CHECK	CHECK	·	·	The customer asked for H2. The old specialist quote never listed H2.	Verify before you sign.
CHECK	CHECK	·	·	The four H2 rooms in the email are on this plan (A0-022, 023, 025, 026).	Noted.
AK	On sheet	1	A0-027	ARMBÅGSKONTAKT	Elbow tap is drawn. Confirm article and whether it belongs in this fittings quote.
AK	On sheet	2	A0-028	ARMBÅGSKONTAKT	Elbow tap is drawn. Confirm article and whether it belongs in this fittings quote.
AK	On sheet	1	·	ARMBÅGSKONTAKT outside entrance	Elbow tap is drawn. Confirm article and whether it belongs in this fittings quote.
IL.4	On sheet	2	·	HILA Inspektionslucka 300x300 mm	From the hatch table on this sheet, not counted on the floor.
IL.5	On sheet	16	·	IL.5 LK Ram/lucka UNI INB UNI 550 590 x 580 x 26 mm	From the hatch table on this sheet, not counted on the floor.
IL.6	On sheet	1	·	LK Ventilskåp med tillhörande lucka 250 x 250 X 95 mm	From the hatch table on this sheet, not counted on the floor.
IL.7	On sheet	2	·	IL.7 HILA Inspektionslucka 300x300 mm	From the hatch table on this sheet, not counted on the floor.
DT10.11V	OTHER TRADE	1	A0-030	DÖRR AV TRÄ, AMALGAMAVSKILJNING	Read from the drawing. Usually another trade · not Ahlsell sakvaror.
DT10.1H	OTHER TRADE	1	A0-004	DÖRR AV TRÄ	Read from the drawing. Usually another trade · not Ahlsell sakvaror.
DT10.5H	OTHER TRADE	1	A0-024	DÖRR AV TRÄ	Read from the drawing. Usually another trade · not Ahlsell sakvaror.
DT10.8V	OTHER TRADE	1	A0-006	DÖRR AV TRÄ	Read from the drawing. Usually another trade · not Ahlsell sakvaror.
DT6.1V	OTHER TRADE	1	·	DÖRR AV TRÄ, DATA	Read from the drawing. Usually another trade · not Ahlsell sakvaror.
DT9.2H	OTHER TRADE	1	A0-008a	DÖRR AV TRÄ	Read from the drawing. Usually another trade · not Ahlsell sakvaror.
DT9.2H	OTHER TRADE	1	A0-009a	DÖRR AV TRÄ	Read from the drawing. Usually another trade · not Ahlsell sakvaror.
DT9.2H	OTHER TRADE	1	·	DÖRR AV TRÄ at right match line	Read from the drawing. Usually another trade · not Ahlsell sakvaror.
DT9.2V	OTHER TRADE	1	A0-009b	DÖRR AV TRÄ	Read from the drawing. Usually another trade · not Ahlsell sakvaror.
DT9.4H	OTHER TRADE	1	A0-002	DÖRR AV TRÄ	Read from the drawing. Usually another trade · not Ahlsell sakvaror.
DT9.4H	OTHER TRADE	1	A0-005	DÖRR AV TRÄ	Read from the drawing. Usually another trade · not Ahlsell sakvaror.
FÖ12.1V	OTHER TRADE	1	A0-026	FÖNSTER ÖPPNINGSBART	Read from the drawing. Usually another trade · not Ahlsell sakvaror.
FÖ12.1V	OTHER TRADE	1	·	FÖNSTER ÖPPNINGSBART at right match line	Read from the drawing. Usually another trade · not Ahlsell sakvaror.
IMP11.1H	OTHER TRADE	1	A0-028	INVÄNDIGT METALLPARTI	Read from the drawing. Usually another trade · not Ahlsell sakvaror.
PDT13.2H	OTHER TRADE	1	A0-023	PARDÖRR AV TRÄ	Read from the drawing. Usually another trade · not Ahlsell sakvaror.
PDT13.2V	OTHER TRADE	1	A0-025	PARDÖRR AV TRÄ	Read from the drawing. Usually another trade · not Ahlsell sakvaror.
PDT13.2V	OTHER TRADE	1	A0-026	PARDÖRR AV TRÄ	Read from the drawing. Usually another trade · not Ahlsell sakvaror.
PDT15.2V	OTHER TRADE	1	A0-022	PARDÖRR AV TRÄ	Read from the drawing. Usually another trade · not Ahlsell sakvaror.
UMP11.2V	OTHER TRADE	1	A0-028	UTVÄNDIGT METALLPARTI	Read from the drawing. Usually another trade · not Ahlsell sakvaror.
H1	OTHER	1	A1-029	Hylla H1; provisional room allowance, length and specification unavailable	This room is in the customer request, not on PLAN 09. Other drawings.
H1	OTHER	1	A1-045	Hylla H1; provisional room allowance, length and specification unavailable	This room is in the customer request, not on PLAN 09. Other drawings.
H1	OTHER	1	A2-030	Hylla H1; provisional room allowance, length and specification unavailable	This room is in the customer request, not on PLAN 09. Other drawings.
H1	OTHER	1	A3-035	Hylla H1; provisional room allowance, length and specification unavailable	This room is in the customer request, not on PLAN 09. Other drawings.
H2	OTHER	1	A1-016	Hylla H2; provisional room allowance, length and specification unavailable	This room is in the customer request, not on PLAN 09. Other drawings.
H2	OTHER	1	A1-017	Hylla H2; provisional room allowance, length and specification unavailable	This room is in the customer request, not on PLAN 09. Other drawings.
H2	OTHER	1	A1-020	Hylla H2; provisional room allowance, length and specification unavailable	This room is in the customer request, not on PLAN 09. Other drawings.
H2	OTHER	1	A1-023	Hylla H2; provisional room allowance, length and specification unavailable	This room is in the customer request, not on PLAN 09. Other drawings.
H2	OTHER	1	A1-039	Hylla H2; provisional room allowance, length and specification unavailable	This room is in the customer request, not on PLAN 09. Other drawings.
H2	OTHER	1	A1-040	Hylla H2; provisional room allowance, length and specification unavailable	This room is in the customer request, not on PLAN 09. Other drawings.
H2	OTHER	1	A1-053	Hylla H2; provisional room allowance, length and specification unavailable	This room is in the customer request, not on PLAN 09. Other drawings.
H2	OTHER	1	A2-040	Hylla H2; provisional room allowance, length and specification unavailable	This room is in the customer request, not on PLAN 09. Other drawings.
H3	OTHER	1	A0-015	Hylla H3; provisional room allowance, length and specification unavailable	This room is in the customer request, not on PLAN 09. Other drawings.

Work in Revu on page 2. Filter NEED and CHECK. Fill those in. You still sign.