GRANITE · FIRST CRACK

Not a quote. Not signed.

This PDF is the BoM API draft stamped on PLAN 09
so a specialist can open it in Bluebeam Revu.

What to do
1. Read page 2 ? the full draft: boxed, not boxed, and notes.
2. Open page 3 in Revu. The Markups List is the first crack.
3. Delete, add, or change. New marks show your author.
4. Save. Drop that save back into Granite to compare.
5. You still sign the quote. Granite does not.

A-40-1-1091 · PLAN 09 · 22 boxes on page 3
Author of every draft box: Granite
Page 2 lists everything that is not boxed, so you are not guessing.
Lengths and kit contents are still questions ? check those first.

FIRST CRACK · CHECK IN REVU · STILL NOT AN ORDER

API claimed 69 lines · 63 recovered · 22 boxes on page 3. This page stays with you in Revu so the missing lines are not a mystery.

ON PAGE 3 ? boxed, Author Granite
22 boxes · 18 draft lines
H2 shelves (4) · TP3 kits (4) · TP2 kits (3)
S1 (3) · elbow taps AK (4) · hatch table IL.4?7 (4)
Filter Markups List by Subject. Delete wrong. Add missing.


NOT BOXED ? still part of the draft
17 lines with no type code (WC, basin, support arms).
19 doors / windows / metal frames (other trade).
2 weak marks (arms, EFT, UDS).
7 lines on other floors (not this sheet).
6 lines cut from the API export.
12 draft notes ? also in Granite.

DRAFT NOTES ? check these first
!! Only this PDF was uploaded. Ten other drawings, the room description and the type standard are missing.
OK The four H2 rooms in the email are on this plan (A0-022, 023, 025, 026).
!! H2 is drawn, but length is not on this floor plan.
!! TP3 / TP2 are package codes. Contents need the type standard.
!! Hatch quantities come from a table on the sheet, not from counting rooms.
!! 17 lines have no type code (WC, basin, support arms, unidentified arms).
!! 10 lines have no room (hatches, match-line items, one elbow tap).
!! S1, EFT20.1V, UDS11.1V and two articulated arms have no product type.
!! The customer asked for H2. The old specialist quote never listed H2.
OK Doors, windows and metal frames are in the draft but kept out of the customer basket (other trade).
OK Request-only H1/H2 on other floors stay out of this basket.
!! Export was cut: 63 of 69 lines recovered. Do not treat the missing 6 as empty.

NO TYPE CODE (no box ? look in Granite list / add in Revu if it is your job)
A0-004 WC-stol, A0-004 Tvättställ, A0-004 Stödarm, A0-024 WC-stol, A0-024 Tvättställ, A0-024 Stödarm, A0-002 Utslagsback, A0-009a WC-stol, A0-009a Tvättställ, A0-009b WC-stol, A0-009b Tvättställ, A0-008a WC-stol, A0-008a Tvättställ, ? WC-stol, partially shown eas, ? Tvättställ, partially shown , A0-025 Unidentified articulated arm, A0-023 Unidentified articulated arm

Revu = first crack on the drawing. Granite = the rest of the draft + notes + compare after you save.
You still sign. Nothing on this page is an order.

GRANITE FIRST CRACK · not a quote · page 2 = full list · this page = boxed draft · delete / add / save · drop the save back into Granite

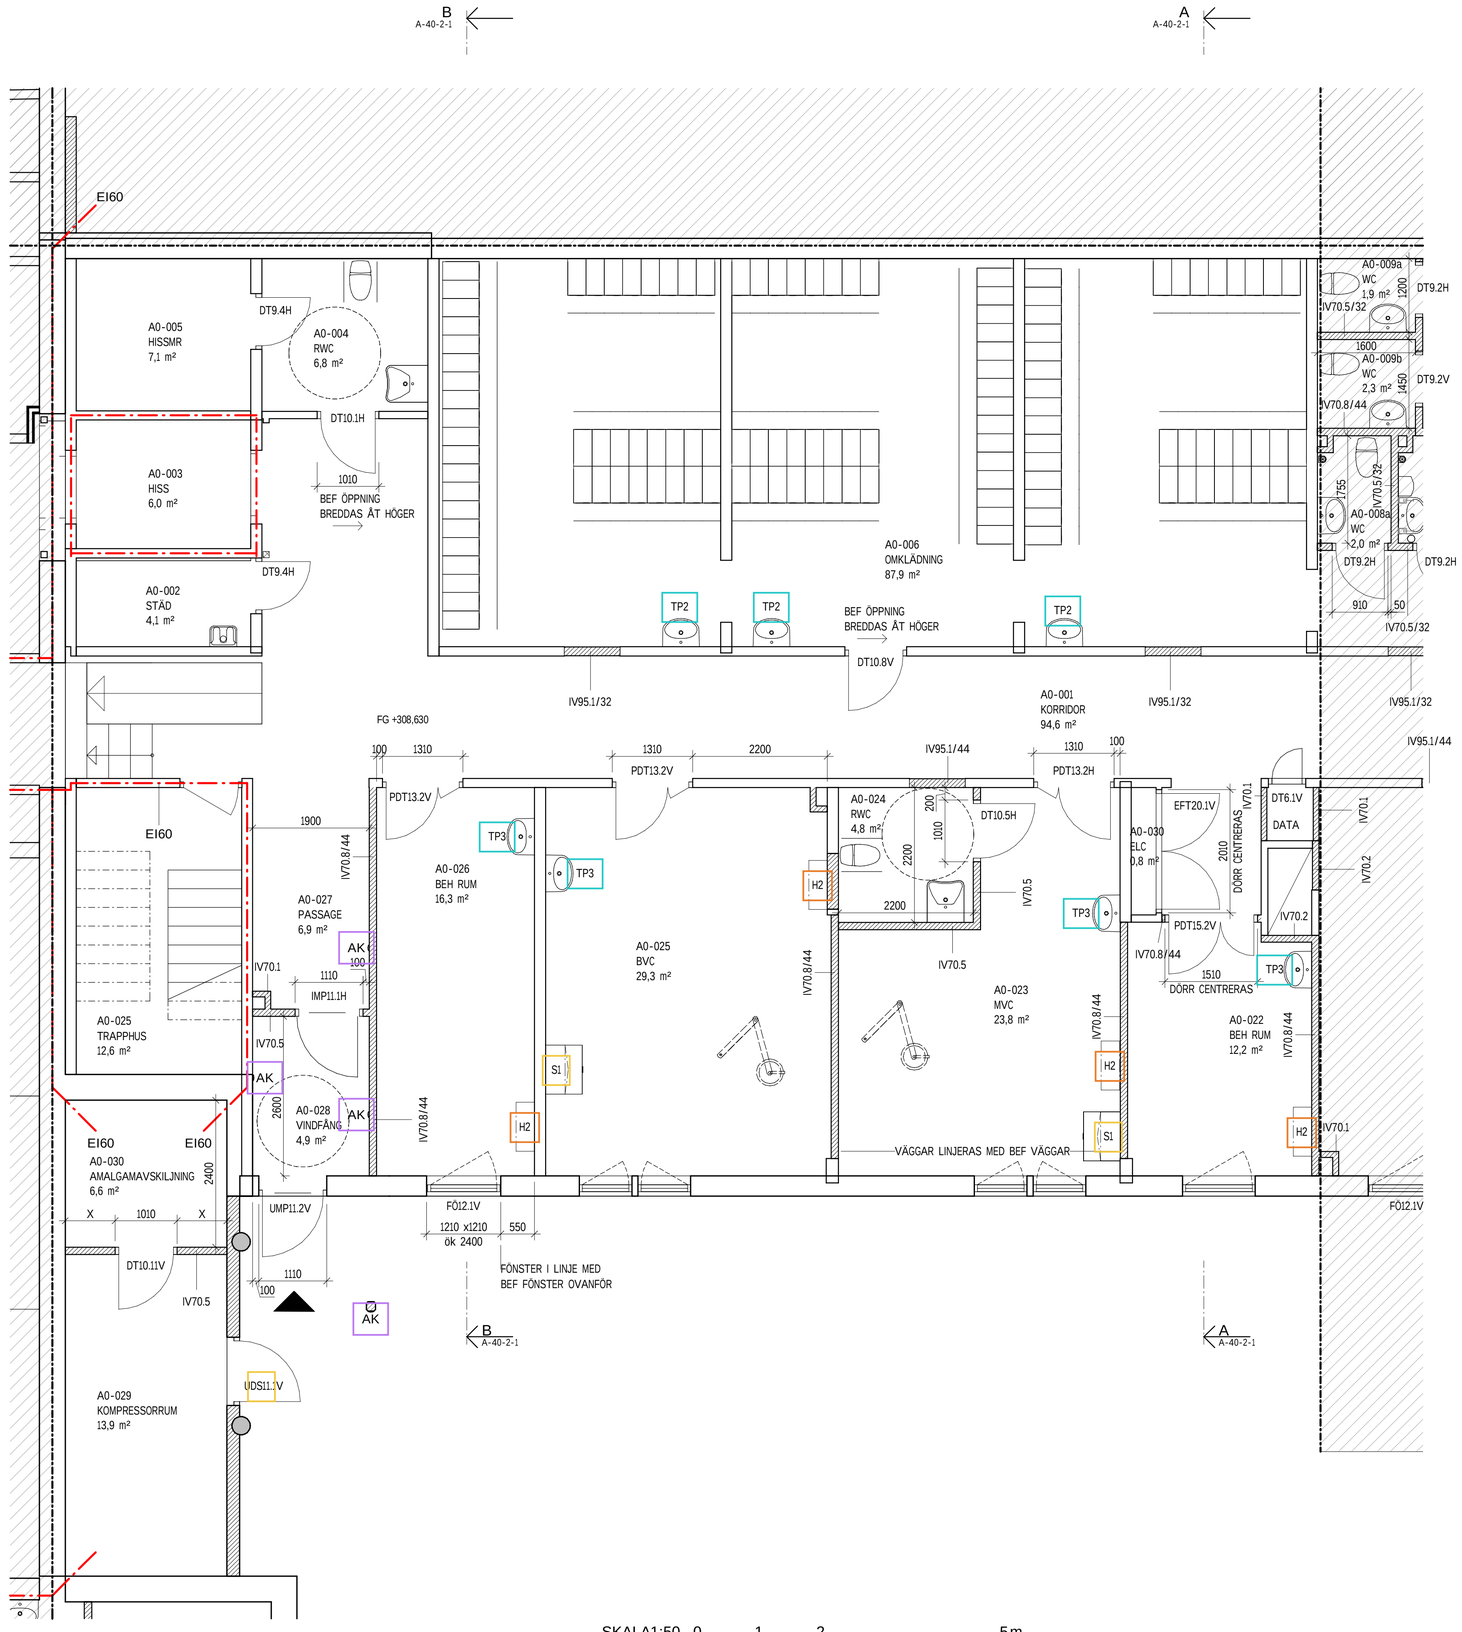

FÖRKLARINGAR

NYA BYGGDELAR

BEFINTLIGA BYGGDELAR

KONNEKTIONSLINJE

BRANDCELLSGRÄNSER:
EI30
EI60

FG + 1,000 PLUSHÖJD - FÄRDIGT GOLV

VÄGGTYPER:
IV70.5 ANGER VÄGG MED REGEL 70 MM
IV70.5/36 ANGER VÄGG MED LJUDKRAV $D_{nT,w}$ 36 dB

LITTERA:

AK	ARMBÅGSKONTAKT
DT	DÖRR AV TRÄ
DTG	DÖRR AV TRÄ, GLASAD
PDT	PARDÖRR AV TRÄ
PDTG	PARDÖRR AV TRÄ, GLASAD
IMP	INVÄNDIGT METALLPARTI
IL	INSPEKTIONSLUCKA
UMP	UTVÄNDIGT METALLPARTI
GP	GLASPARTI AV TRÄ
FÖ	FÖNSTER ÖPPNINGSBART
K	KYLSKÅP
F	FRYS
KF	KYL/FRYS
DM	DISKMASKIN
M	MIKROVÅGSUGN
HS	HÖRNSKYDD
SG	SKRAPGALLER
TM	TORKMATTA
TP	TVÄTTPLATSUTRUSTNING
PL	PROVLUCKA

FÖRESKRIFTER

BRAND:
VÄGGAR SKA UTFÖRAS I BRANDKLASS ENL BRANDSKYDDSBESKRIVNING OCH BRANDCELLSINDELNING PÅ BRANDSKYDDSRITNINGAR.
VID AVVIKELSER MELLAN A- RITNINGAR OCH BRANDSKYDDSRITNINGAR GÄLLER UTFÖRANDE ENLIGT BRANDSKYDDSRITNINGAR.

INSPEKTIONSLUCKOR:
PLACERING OCH HÖJD SAMORDNAS MED VS

Littera	Typ	Antal	Brandklass
IL.4	HILA Inspektionslucka 300x300 mm	2	EI30
IL.5	IL.5 LK Ram/lucka UNI INB UNI 550 590 x 580 x 26 mm	16	-
IL.6	LK Ventilskåp med tillhörande lucka 250 x 250 X 95 mm	1	-
IL.7	IL.7 HILA Inspektionslucka 300x300 mm	2	-

BET	ÄNDRINGEN AVSER	DATUM	SIGN

BYGGHANDLING

NY VÅRDBYGGNAD

EXEMPELVÄGEN 2


X	A	Exempel Arkitektstudio	tel. 000-000 00 00
	K	KONSULT A	tel. 000-000 00 00
	E	KONSULT A	tel. 000-000 00 00
	V	KONSULT A	tel. 000-000 00 00
	VS	KONSULT A	tel. 000-000 00 00
	B	KONSULT C	tel. 000-000 00 00
	M	KONSULT A	tel. 000-000 00 00
	S	KONSULT A	tel. 000-000 00 00
	GAS	KONSULT B	tel. 000-000 00 00
	SP	KONSULT D	tel. 000-000 00 00

DATUM	RITAD/KONSTR AV	HANDLÄGGARE
2025-02-28	Arkitekt G	Arkitekt G
SKALA	ANSVARIG	UPPDRAGSNR
A1 1:50	Arkitekt H	90020

OM- OCH TILLBYGGNAD

FLYGEL A - PLAN 09, DEL 1
PLANRITNINGAR

FASTIGHETSNUMMER	NUMMER	BET
0001	A-40-1-1091	

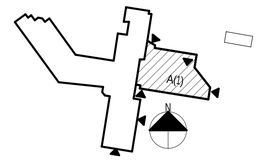

SKALA1:50 0 1 2 5m

2025-02-28 14:52:22