GRANITE · FIRST CRACK

# Not a quote. Not signed.

This PDF is the BoM API draft as Revu markups.
Every recovered line is already in the Markups List.

What to do

1. Open page 3 in Revu. Alt+L ? that list is the first crack.
2. Filter NEED and CHECK. Those need your input. Do not re-type them.
3. Delete wrong. Fill missing. New marks show your author.
4. Save. Drop that save back into Granite to compare.
5. You still sign the quote. Granite does not.

A-40-1-1091 · PLAN 09 · 76 markups in the list
Author Granite. Page 2 is only a legend for the Subjects.
NEED = missing info. CHECK = a note. OTHER = not this sheet.

**FIRST CRACK · CHECK IN REVU · STILL NOT AN ORDER**

## MARKUPS LIST · how to read the first crack

All 76 draft items are already in Revu?s Markups List. You do not copy them in. Filter by Subject. Fill in NEED and CHECK. You still sign.

| Subject · what it means | |
|---|---|
| H2 / TP3 / IL.5 / AK ? | a counted mark on this sheet. Confirm qty and spec. |
| NEED | no type code or missing length/kit. You fill this in. |
| CHECK | a draft note. Verify before you sign. |
| OTHER | on another floor. Keep on the list, not this sheet. |
| DT / PDT / FÖ / IMP | door, window, frame. Other trade ? confirm if yours. |


Author of every first-crack box: Granite. Your adds will show your name.

Work the list, not page 1.

1. Open page 3. Alt+L (Markups List).
2. Filter Subject = NEED, then CHECK.
3. Edit Comment / add a product. Delete what is wrong.
4. Save. Drop the save back into Granite.
5. Still not an order until you sign.

**FIRST CRACK · FILL NEED AND CHECK · STILL NOT AN ORDER**

GRANITE FIRST CRACK · whole draft is in the Markups List · filter NEED and CHECK · fill those in · you still sign

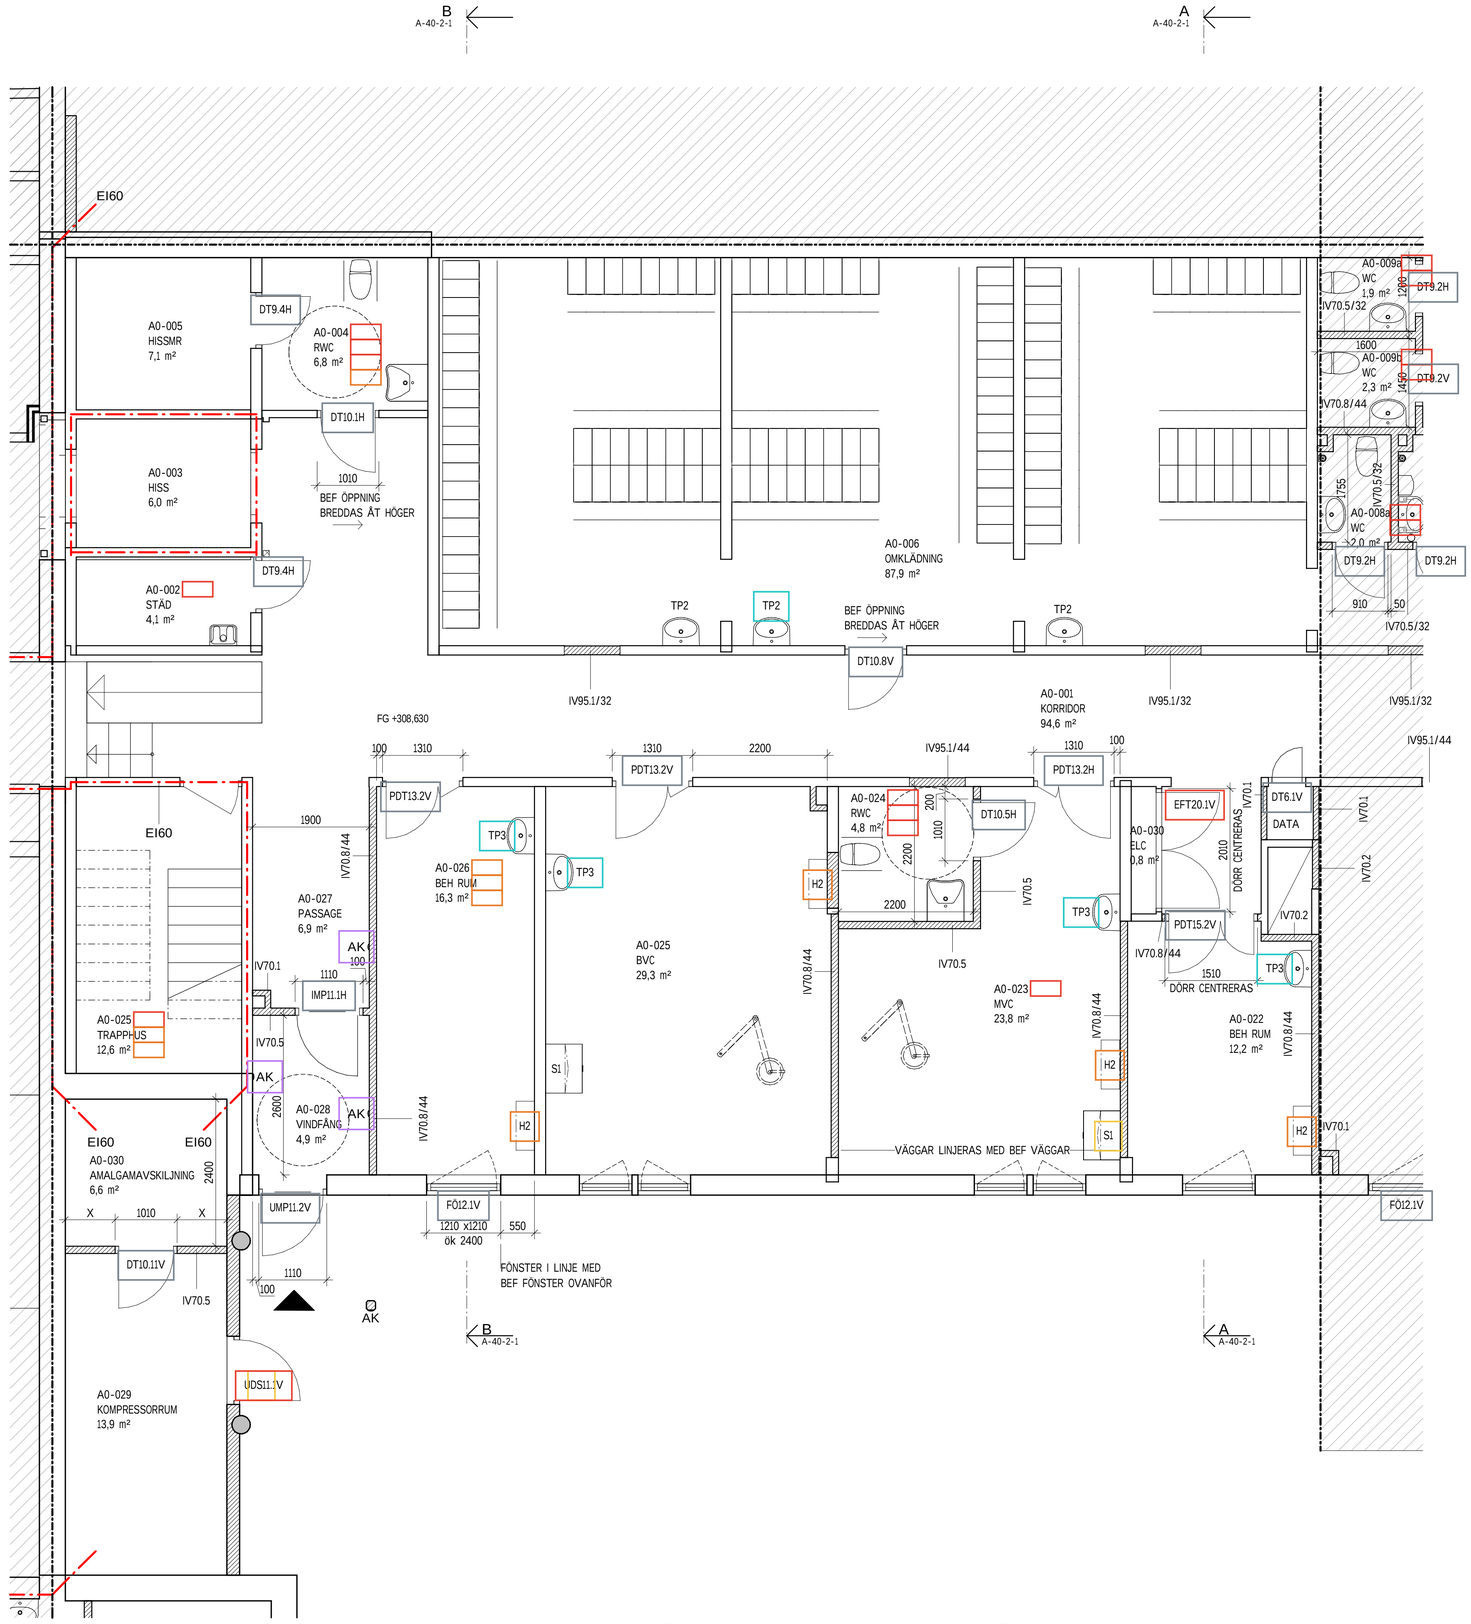


## FÖRKLARINGAR

NYA BYGGDELAR

BEFINTLIGA BYGGDELAR

KONNEKTIONSLINJE

BRANDCELLSGRÄNSER:
- E30
- EI30
- EI60

FG + 1,000 PLUSHÖJD - FÄRDIGT GOLV

VÄGGTYPER:
IV70.5 ANGER VÄGG MED REGEL 70 MM
IV70.5/36 ANGER VÄGG MED LJUDKRAV $D_{nT,w}$ 36 dB

LITTERA:

| | |
|---|---|
| AK | ARMBÅGSKONTAKT |
| DT | DÖRR AV TRÄ |
| DTG | DÖRR AV TRÄ, GLASAD |
| PDT | PARDÖRR AV TRÄ |
| PDTG | PARDÖRR AV TRÄ, GLASAD |
| IMP | INVÄNDIGT METALLPARTI |
| IL | INSPEKTIONSLUCKA |
| UMP | UTVÄNDIGT METALLPARTI |
| GP | GLASPARTI AV TRÄ |
| FÖ | FÖNSTER ÖPPNINGSBART |
| K | KYLSKÅP |
| F | FRYS |
| KF | KYL/FRYS |
| DM | DISKMASKIN |
| M | MIKROVÅGSUGN |
| HS | HÖRNSKYDD |
| SG | SKRAPGALLER |
| TM | TORKMATTA |
| TP | TVÄTTPLATSUTRUSTNING |
| PL | PROVLUCKA |


## FÖRESKRIFTER

BRAND:
VÄGGAR SKA UTFÖRAS I BRANDKLASS ENL BRANDSKYDDSBESKRIVNING OCH BRANDCELLSINDELNING PÅ BRANDSKYDDSRITNINGAR.
VID AVVIKELSER MELLAN A- RITNINGAR OCH BRANDSKYDDSRITNINGAR GÄLLER UTFÖRANDE ENLIGT BRANDSKYDDSRITNINGAR.

INSPEKTIONSLUCKOR:
PLACERING OCH HÖJD SAMORDNAS MED VS

| Littera | Typ | Antal | Brandklass |
|---|---|---|---|
| IL.4 | HILA Inspektionslucka 300x300 mm | 2 | EI30 |
| IL.5 | IL.5 LK Ram/lucka UNI INB UNI 550 590 x 580 x 26 mm | 16 | - |
| IL.6 | LK Ventilskåp med tillhörande lucka 250 x 250 X 95 mm | 1 | - |
| IL.7 | IL.7 HILA Inspektionslucka 300x300 mm | 2 | - |

SKALA1:50 0 1 2 5m

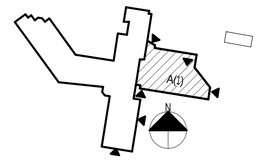


| BET | ÄNDRINGEN AVSER | DATUM | SIGN |
|---|---|---|---|

BYGGHANDLING

# NY VÅRDBYGGNAD

EXEMPELVÄGEN 2

| | | |
|---|---|---|
| A | Exempel Arkitektstudio | tel. 000-000 00 00 |
| K | KONSULT A | tel. 000-000 00 00 |
| E | KONSULT A | tel. 000-000 00 00 |
| V | KONSULT A | tel. 000-000 00 00 |
| VS | KONSULT A | tel. 000-000 00 00 |
| B | KONSULT C | tel. 000-000 00 00 |
| M | KONSULT A | tel. 000-000 00 00 |
| S | KONSULT A | tel. 000-000 00 00 |
| GAS | KONSULT B | tel. 000-000 00 00 |
| SP | KONSULT D | tel. 000-000 00 00 |

| | | |
|---|---|---|
| DATUM 2025-02-28 | RITAD/KONSTR AV Arkitekt G | HANDLÄGGARE Arkitekt G |
| SKALA A1 1:50 | ANSVARIG Arkitekt H | UPPDRAGSNR 90020 |

OM- OCH TILLBYGGNAD

FLYGEL A - PLAN 09, DEL 1
PLANRITNINGAR

| FASTIGHETSNUMMER | NUMMER | BET |
|---|---|---|
| 0001 | A-40-1-1091 | |

2025-02-28 14:52:22